


Res. Door

1440 Window

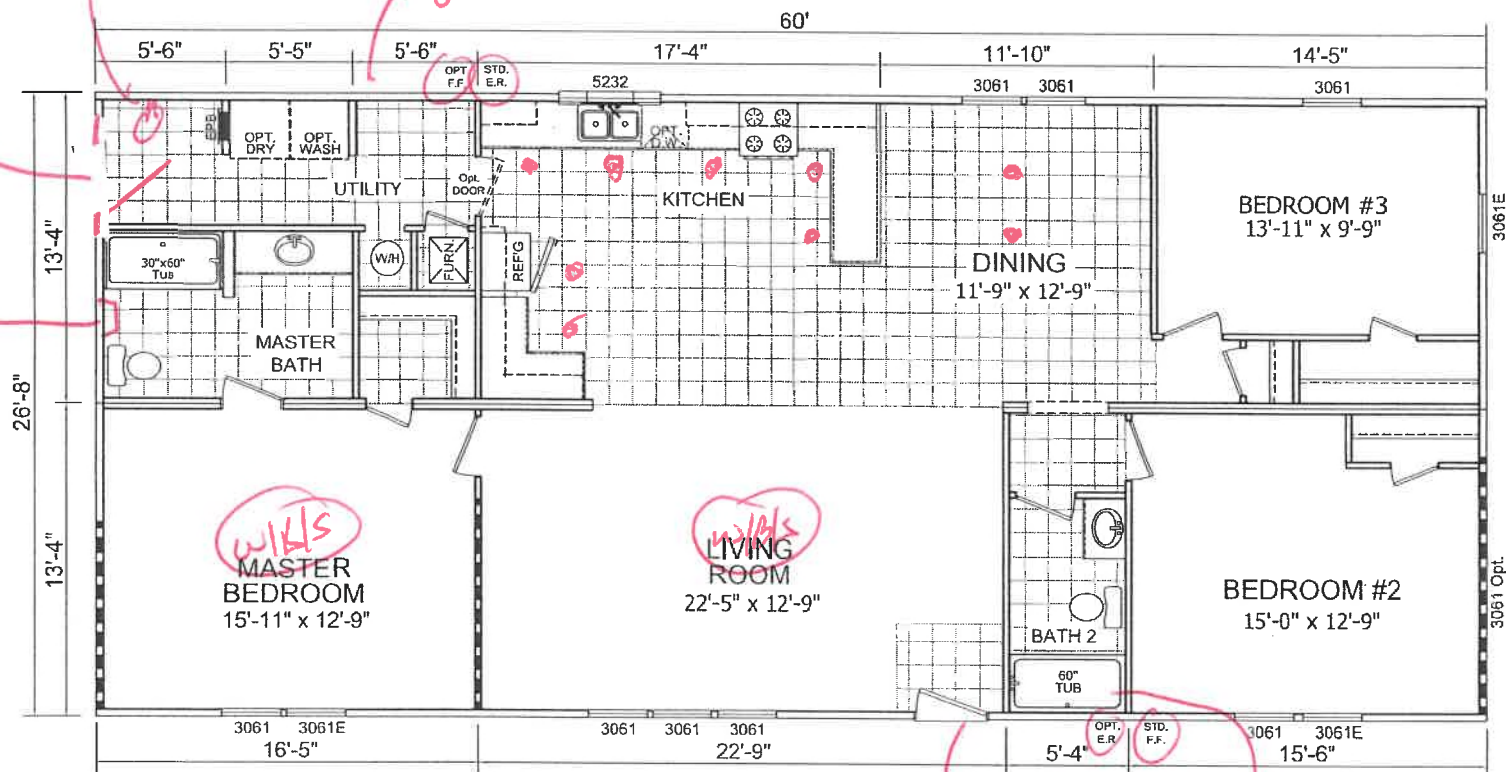

SIGN-OFF

RETAILER: _____ DATE: _____
 CUSTOMER: _____ DATE: _____

CONTROL # 6268

THIS PRELIMINARY AS-BUILT DRAWING MAY CONTAIN ITEMS NOT TYPICALLY STANDARD IN THIS PRODUCT LINE-PLEASE SEE YOUR HOME'S SPECIFIC ORDER AND SPECIFICATIONS FOR A BREAKDOWN OF WHAT IS STANDARD AND OPTIONAL.



308 SHERIDAN DRIVE TOPEKA, IN 46571

APPROVER'S SEAL

MODIFICATIONS

1	REMOVE ACCENT WALLS	LM	10-02-12
2	2014 SPECS		08-27-13
3	CHANGED REFER DOOR SWING	JJF	06-01-17
4	ADDED LINO IN HALL	JR	12-13-18

PROPRIETARY AND CONFIDENTIAL
 THESE DRAWINGS AND SPECIFICATIONS ARE ORIGINAL
 PROPRIETARY AND CONFIDENTIAL MATERIALS OF CHAMPION.
 COPYRIGHT © 1976-2011 BY CHAMPION

MODEL: 2864 211 NELSON
 4BED 2BATH

TITLE: LITERATURE PLAN

DRAWN BY: T. Cowley

DATE: 06-03-20

SCALE: 1/8" = 1'-0"

SHEET:

L-101

2864 NHS

Res Door